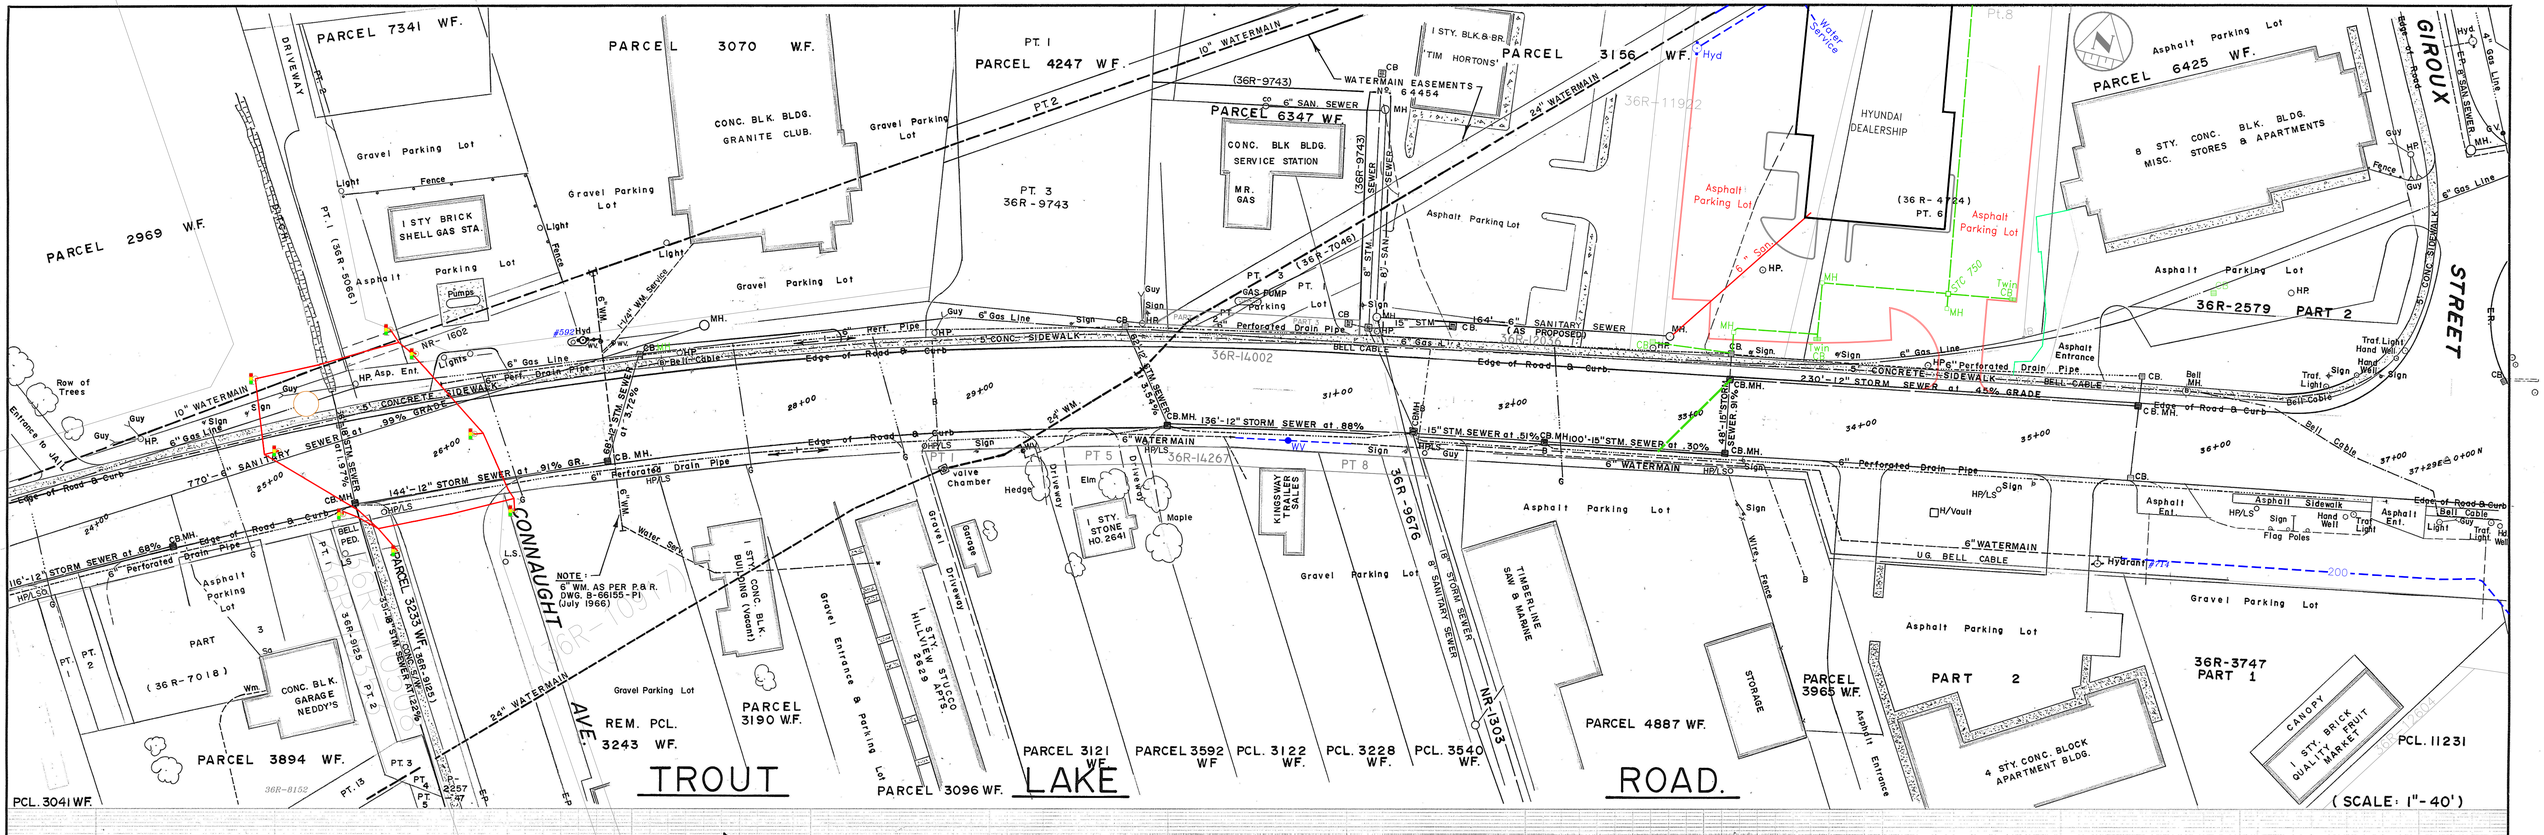

CHAINAGE	GROUND El.	INVERT
24+00	717.65	
24+40	718.03	W-713.00
24+50	718.41	
25+00	718.41	
25+45	718.80	N-713.30 S-713.20 E-713.29
25+50	718.80	
26+00	719.17	
26+50	719.56	
26+88	719.87	W-714.60 N-714.67
27+00	719.87	
27+13	720.06	S-717.20
27+50	720.06	
27+52	720.11	W-715.49
28+00	720.11	
28+50	719.97	
29+00	719.68	
29+50	719.19	
29+82	718.61	S-715.50
30+00	718.61	N-713.30 E-713.20
30+07	718.02	
30+50	718.02	
31+00	717.45	
31+20	717.45	N-711.65 S-709.74 E-709.07
31+40	716.87	W-N-710.00 S-710.00 E-710.50
31+50	716.87	
32+00	716.39	
32+18	716.39	W-710.90 E-711.00
32+50	716.09	
32+84	716.03	W-711.71
33+00	716.03	
33+21	716.03	Rt. W-711.30 S-711.40 Lt. W-711.80 N-E-711.80
33+50	716.28	
34+00	716.60	
34+50	716.95	
35+00	717.30	
35+50	717.65	W-712.80 N-S-712.80
35+55	717.65	
36+00	718.00	
36+50	718.35	
37+00	718.70	
37+29	718.93	
37+50	719.05	

NOTES:

DISCLAIMER

The information contained on this drawing may be based upon data provided by others and may not have been verified by either as-constructed drawings or an Ontario Land Surveyor. The City of North Bay cannot accept responsibility for any errors or omissions on any information shown herein. Field verification, land surveys or excavation (with City approvals) may be required to determine actual location of any and all utilities or property lines.

No.	REVISION	DATE	INITIAL
8.	HYUNDIA DEALERSHIP SITE DETAIL	JAN. '09	J.ST.P.
9.	Removed WV from 10" main as per P/W	Oct. '13	G.W.C.
10.	Added Water to Perut Place and Legals	Apr. '15	G.W.C.
11.	Added 36R-14002	Mar 2017	M.R.
12.	Traffic Lights added (approx. location)	Sept '20	rjo

No.	REVISION	DATE	INITIAL
1.	NEW DRAWING, Detail from M.T.C. TOPO.	FEB. 77.	R.F.B.
2.	UG. BELL CABLE to FRUIT MARKET	AUG. 78	
3	UPDATE DETAIL 30+50, BELL GAS X-ING.	APR. 86	Rick B.
4.	REVISED 10"Wm.& 24"Wm. Location EASE.64454	MAR. 87	Rick B.
5.	HYDRO POLE LOCATION UPDATED	NOV. 93	P.L.C.
6.	ADD NEW SAN. & STM. SEWER ON OLD DRIVE-IN	FEB-94	P.L.C.
7.	SANITARY SEWER-31+20 TO 32+84(FROM PROP.)	MAR. 97	RT

APPROVED

TROUT LAKE ROAD
CITY JAIL TO GIROUX ST.

CITY OF NORTH BAY
ENGINEERING DEPARTMENT

SCALE: AS SHOWN

DATE: FEB. 1977.

DRAWN BY: Rick B.
CK'D. BY:

FIELD BOOK No. 227

DRAWING No. T-204

REV.

DWG. No.

I:\CADJP Drawings\T-204.dwg