


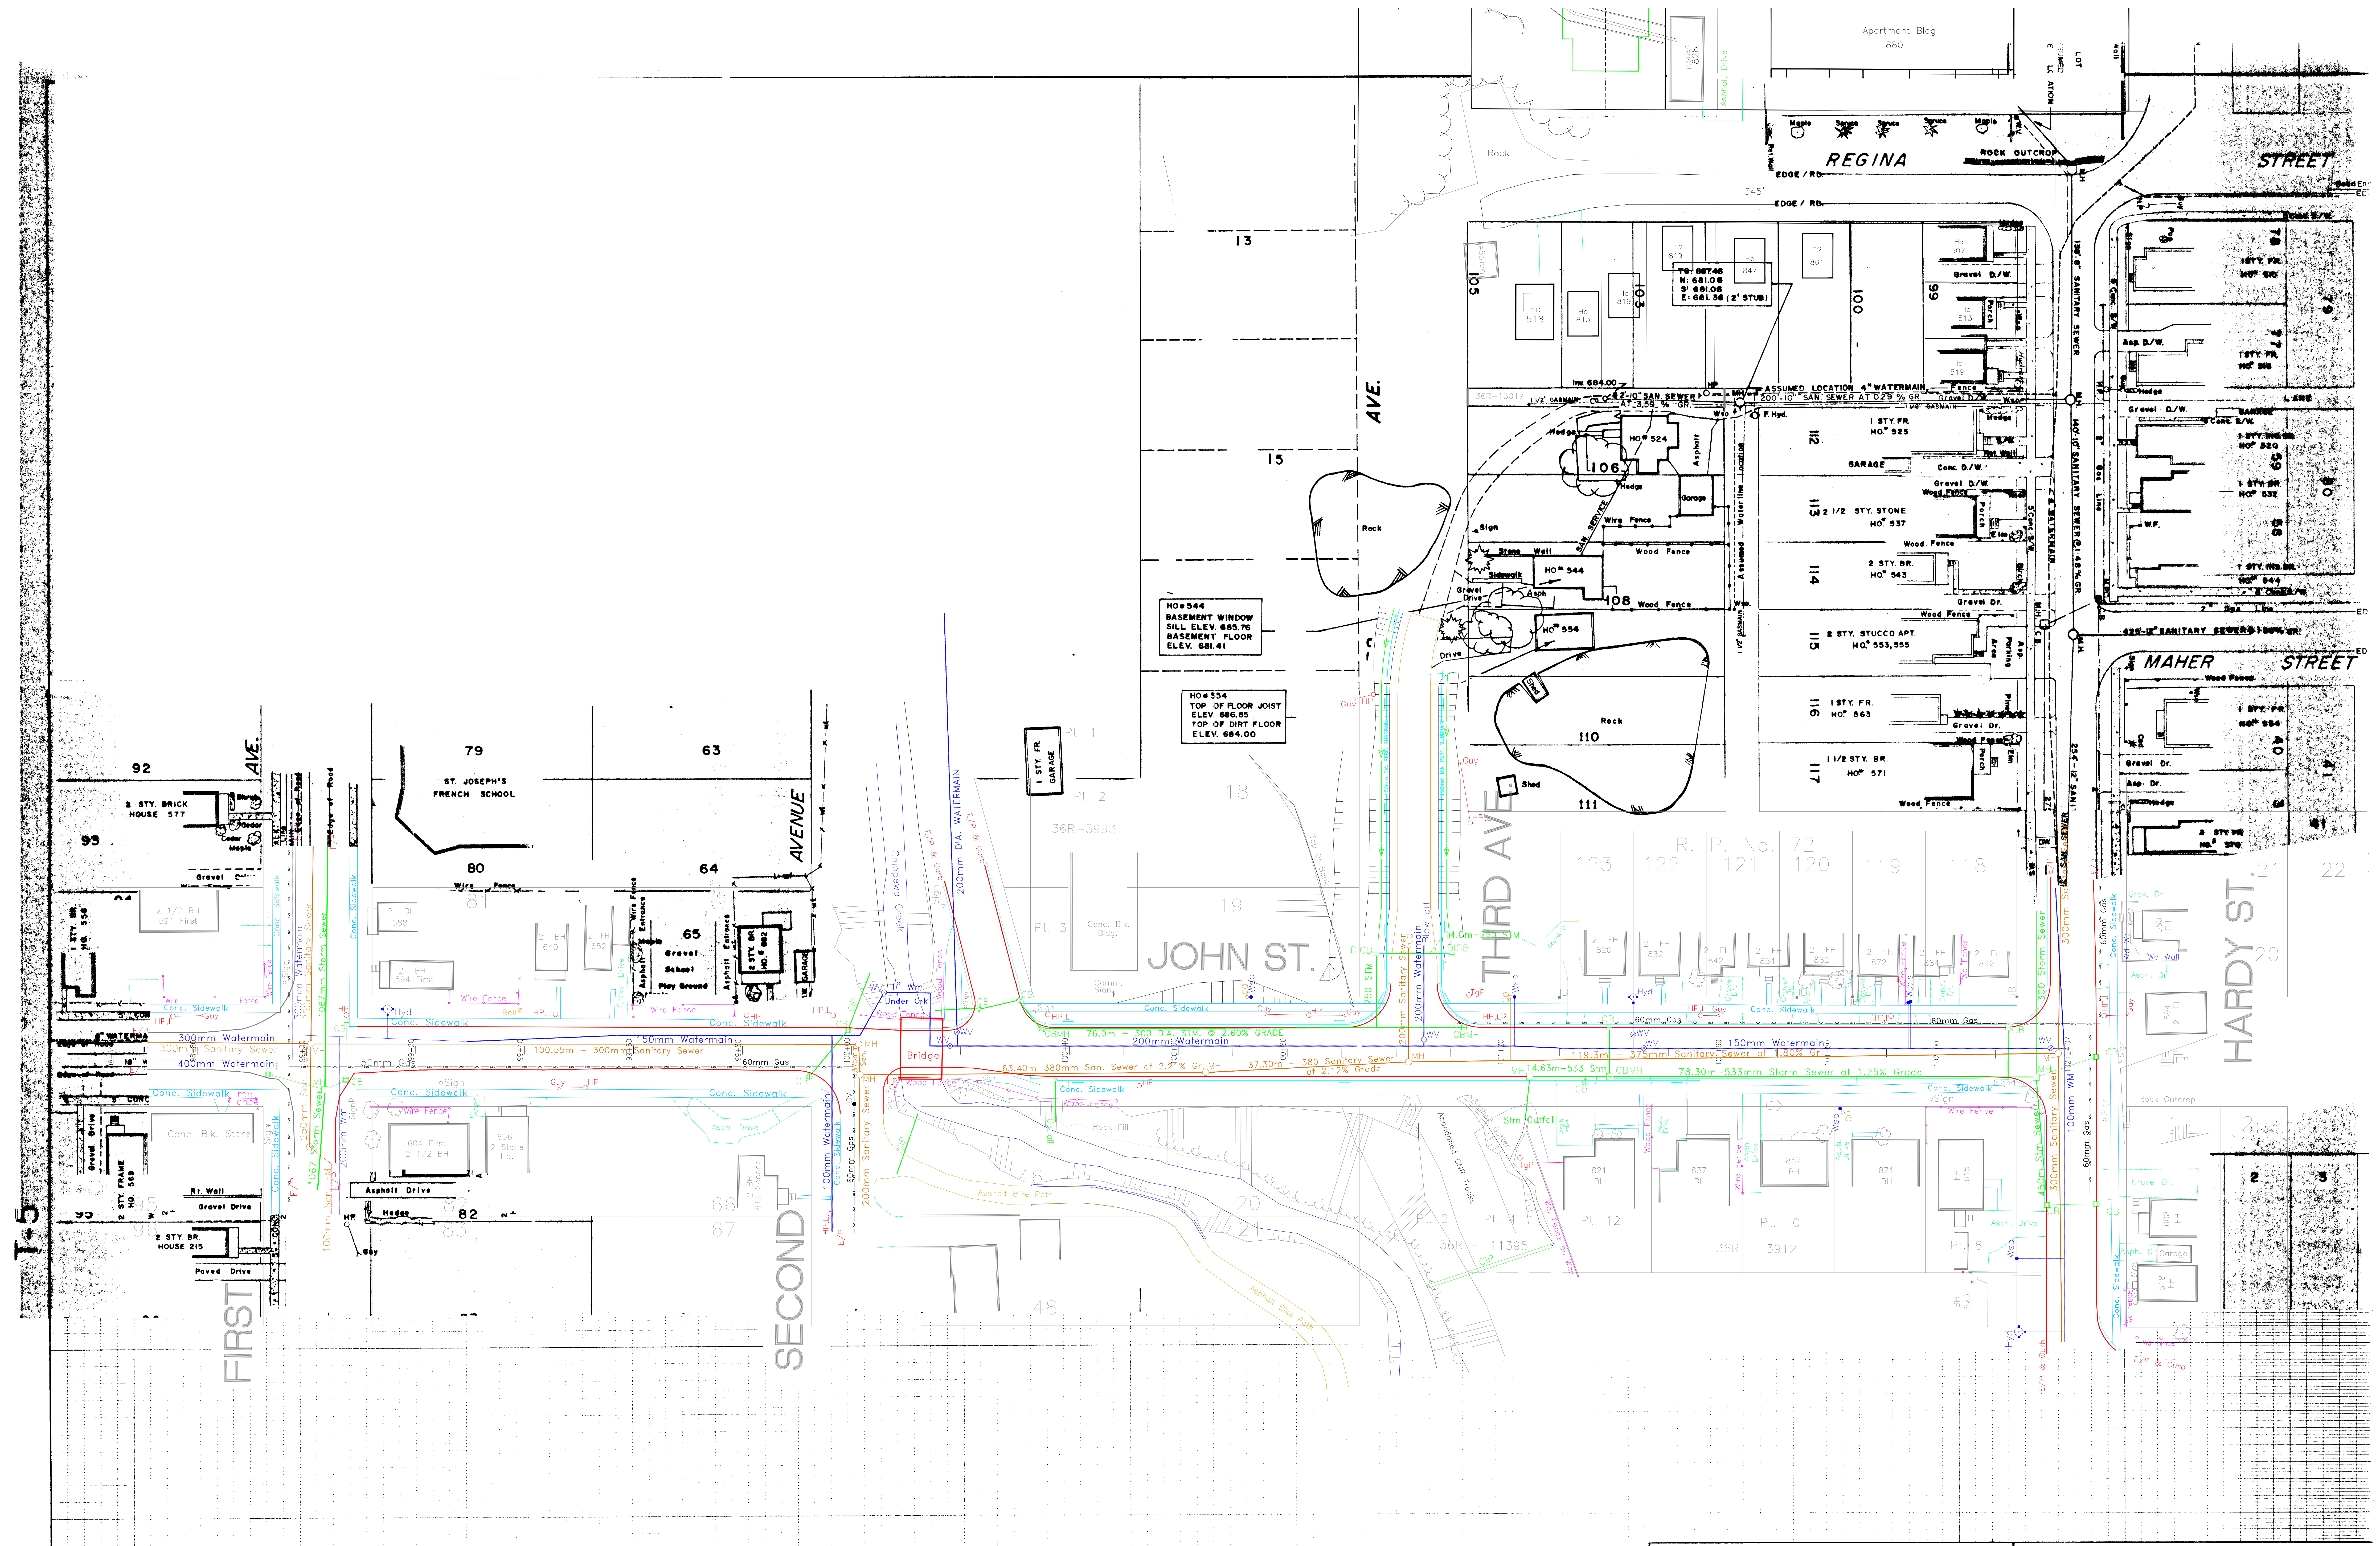

Disclaimer
The information contained on this drawing may be based upon data provided by others and may not have been verified by either as-constructed drawings or an Ontario Land Surveyor. The City of North Bay cannot accept responsibility for any errors or omissions on any information shown herein. Field verification, land surveys or excavation (with City approvals) may be required to determine actual location of any and all utilities or property lines.

Updated John Street Added 36R-13017		Oct/09 Feb/11	G.W.C. G.W.C.	CITY OF NORTH BAY ENGINEERING DEPARTMENT	
SCALE: 1 inch = 50 feet		DATE:		DRAWN BY: C.E.D. BT	
FIELD BOOK No.		DRAWING No.		REV	
		T-5			