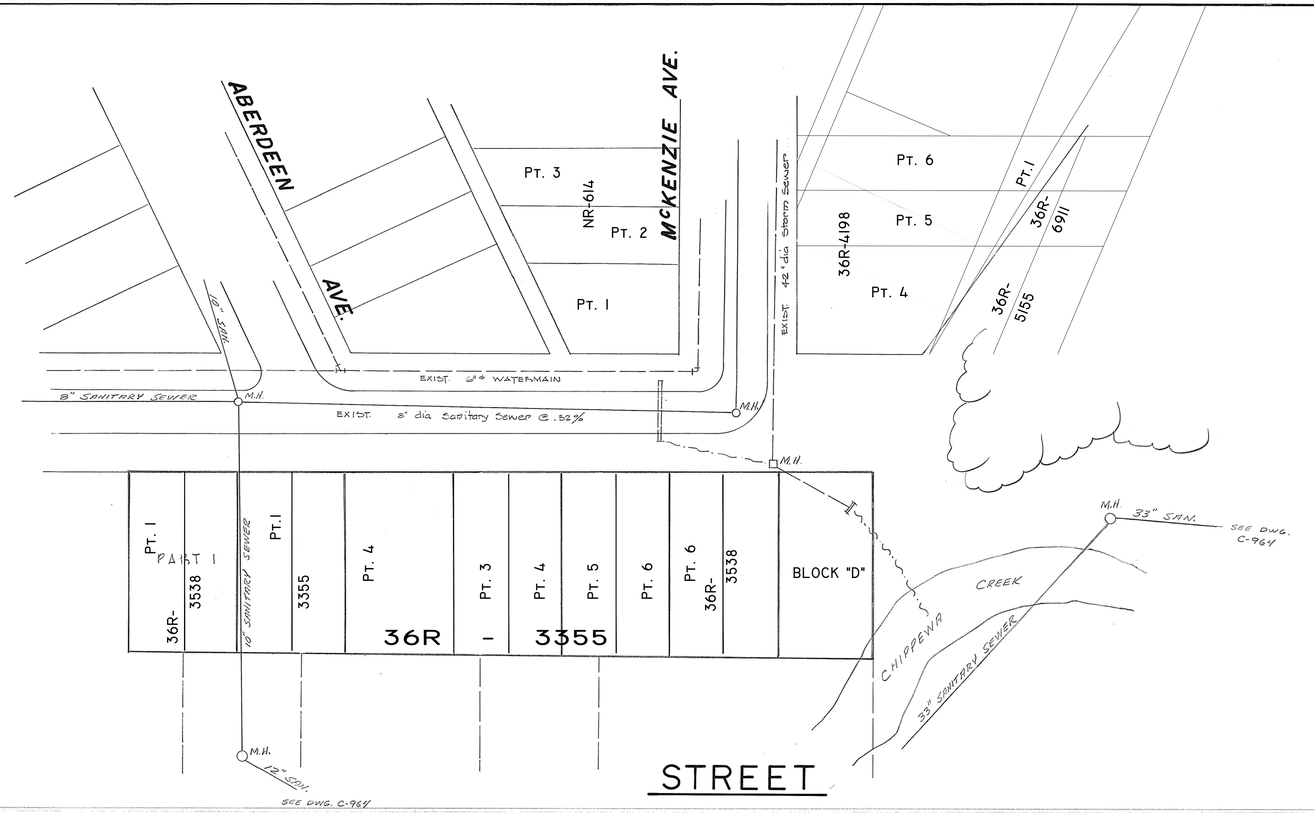

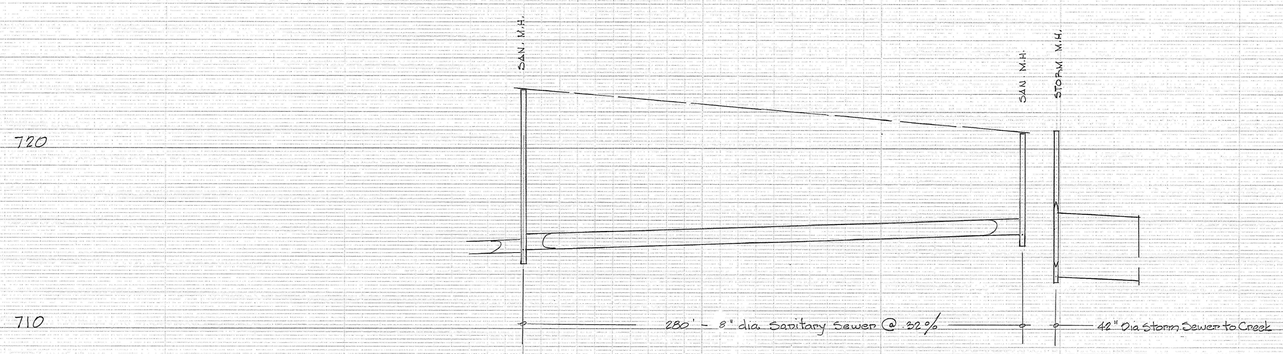

CHAINAGE	GROUND EL	INVERT
	714.4	
	715.55	
	715.44	
	712.84	

DMC' 1/0"

NOTES:

DISCLAIMER

The information contained on this drawing may be based upon data provided by others and may not have been verified by either as-constructed drawings or an Ontario Land Surveyor. The City of North Bay cannot accept responsibility for any errors or omissions on any information shown herein. Field verification, land surveys or excavation (with City approvals) may be required to determine actual location of any and all utilities or property lines.

No.	REVISION	DATE	INITIAL
1.	AS CONST.- CHIPPEWA VALLEY TRUNK	JULY 82	J.S.

APPROVED

VANIER STREET

ABERDEEN AVE. TO McKENZIE AVE.

CITY OF NORTH BAY

ENGINEERING DEPARTMENT

SCALE: AS NOTED DATE: JUNE 1972

DRAWN BY: CK'D BY: | FIELD BOOK No. | DRAWING No. V-51 | REV.